NOTE:
1. ALL ID NUMBERS SHOWN ON THIS SHEET HAVE A PREFIX OF SB-09, UNLESS NOTED OTHERWISE.

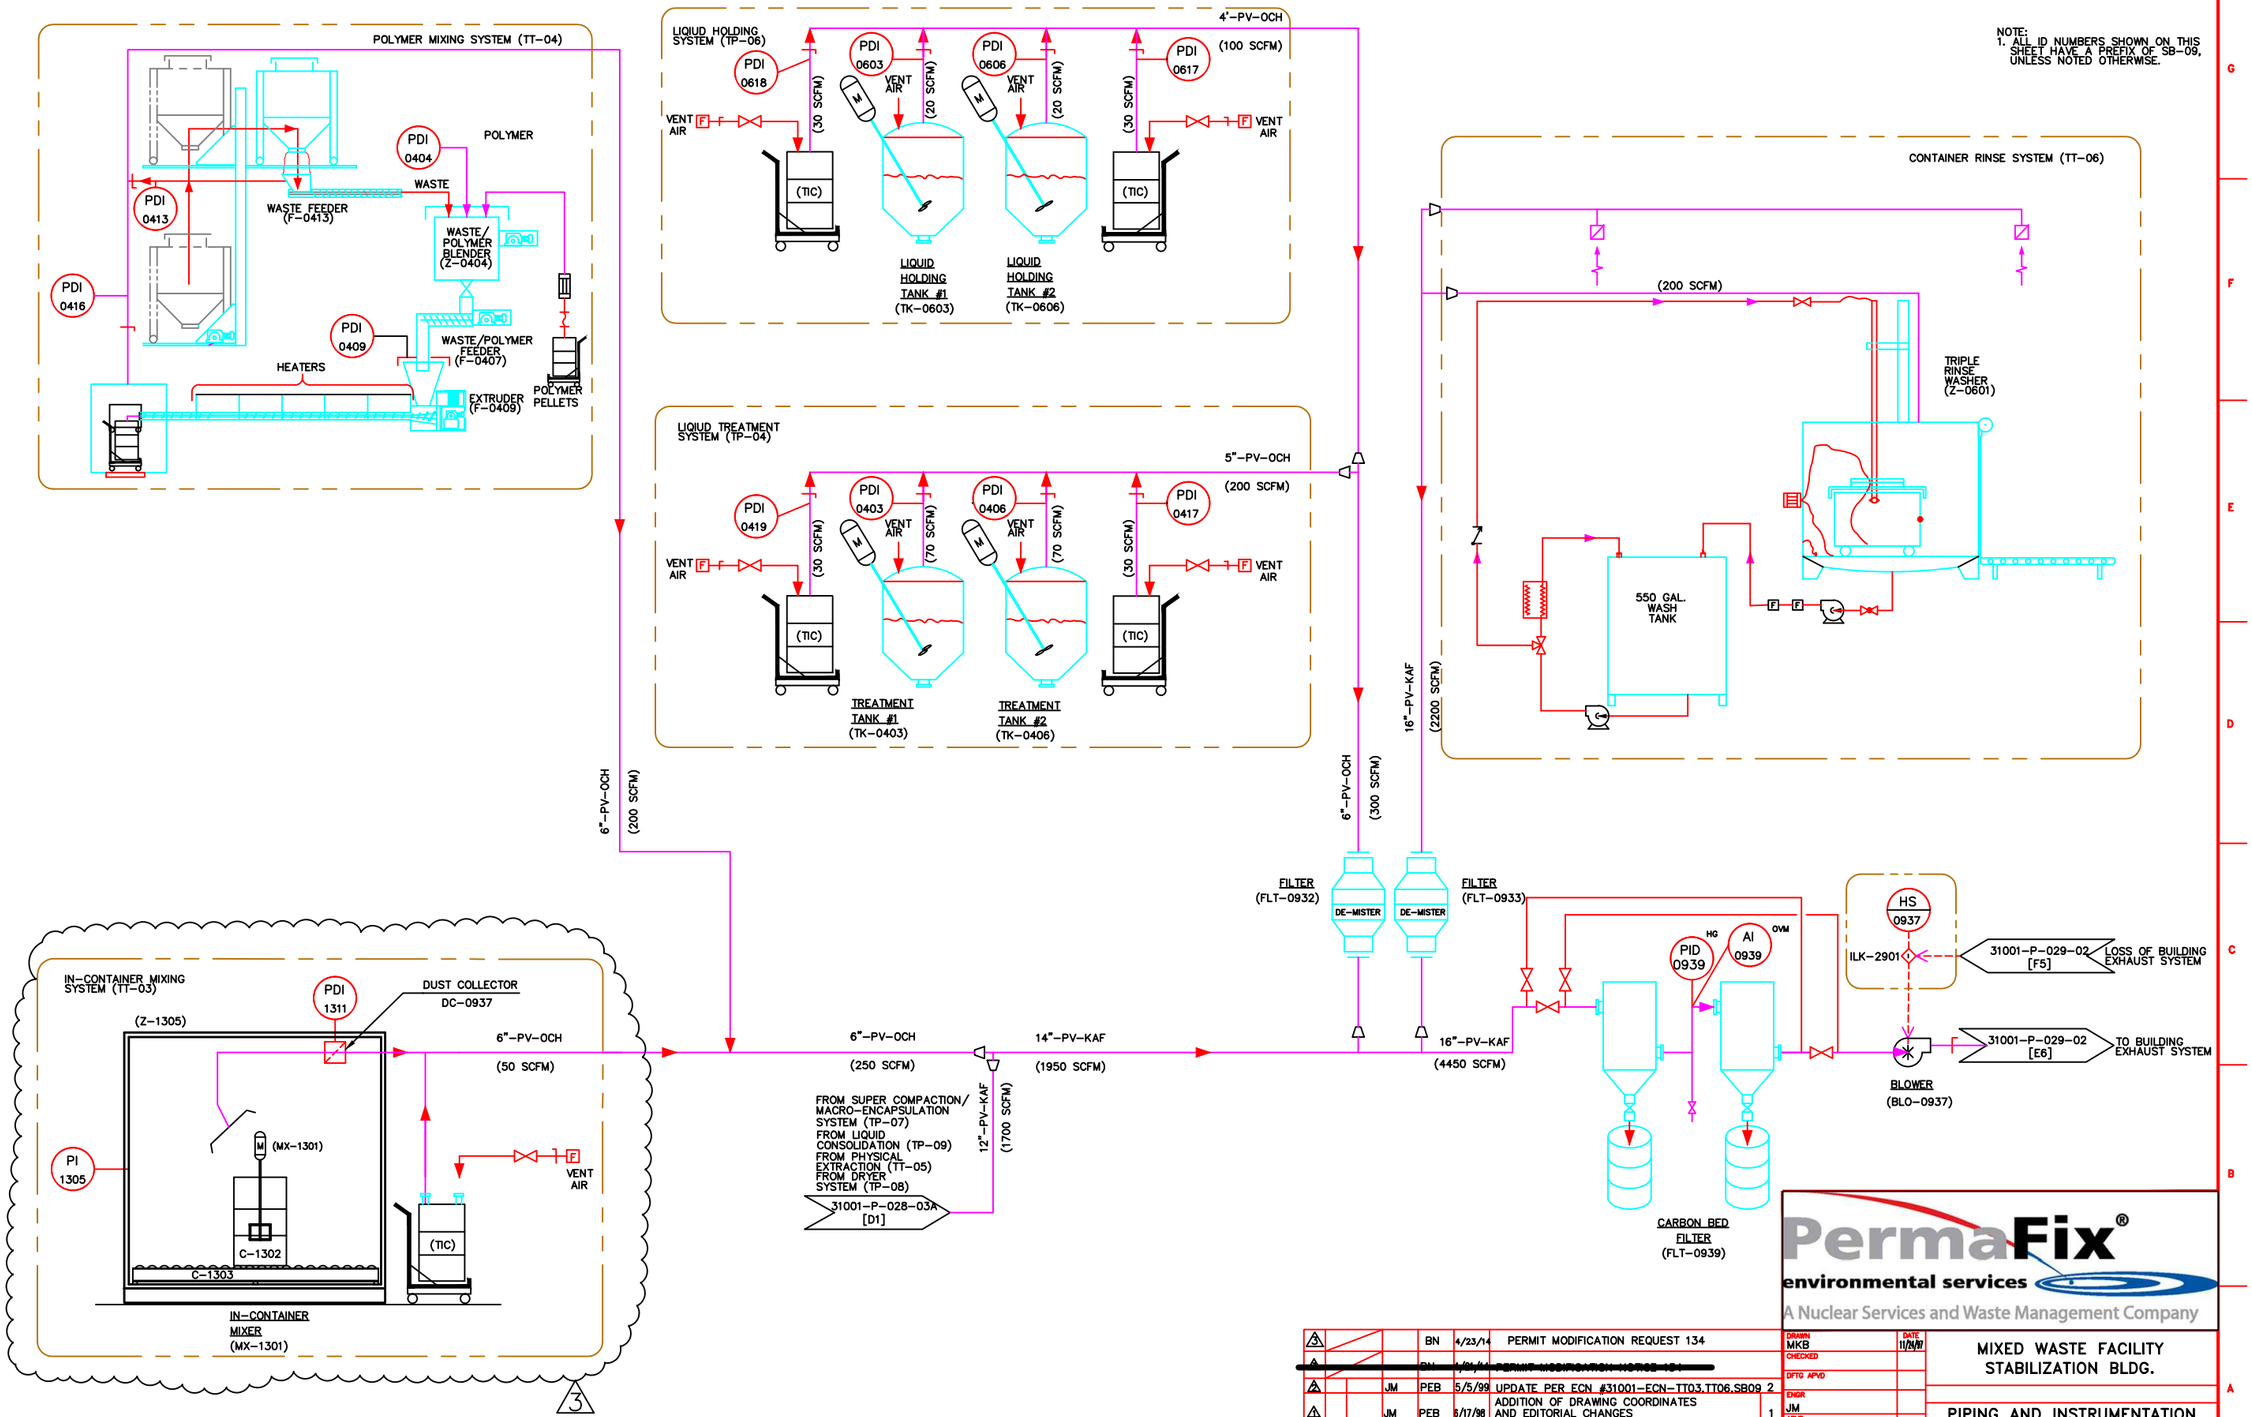

PermaFix® environmental services
A Nuclear Services and Waste Management Company

REV	DESCRIPTION	RR	MF	QA BY	DATE	ENGR BY	DATE	CHK BY	DATE	REV BY	DATE
3	PERMIT MODIFICATION REQUEST 134					BN	4/23/14				
~~2~~	~~PERMIT MODIFICATION NOTICE 134~~					~~BN~~	~~4/24/14~~				
2	UPDATE PER ECN #31001-ECN-TT03,TT06,SB09 2					JM	PEB	5/5/99			
1	ADDITION OF DRAWING COORDINATES AND EDITORIAL CHANGES					JM	PEB	5/17/98			
0	ISSUE FOR EPA PERMIT APPLICATION					JM	PEB	2/16/98			

REVISIONS

CADCODE ACADR13 CADFILE 97211

DRAWN	MKB
DATE	11/24/97
CHECKED	
DFTG APVD	
ENGR	JM
APVD	
OTHER	
QA	

APPROVED FOR IMPLEMENTATION
BY ____ FOR ____ DATE ____

MIXED WASTE FACILITY STABILIZATION BLDG.

PIPING AND INSTRUMENTATION DIAGRAM-STABILIZATION PROCESS VENT (FUME EXHAUST SYSTEM)

SCALE NONE | SHEET NO 4 | SHEETS 4 | REV 3

DWG NO 31001-P-028-03B

PERMIT FIGURE NUMBER: NONE

DRAWING NO	DRAWING TITLE
31001-P-028-03B SHT 4	P&ID 0937 PROCESS VENT

REFERENCE DRAWINGS
NEXT HIGHER ASSEMBLY: